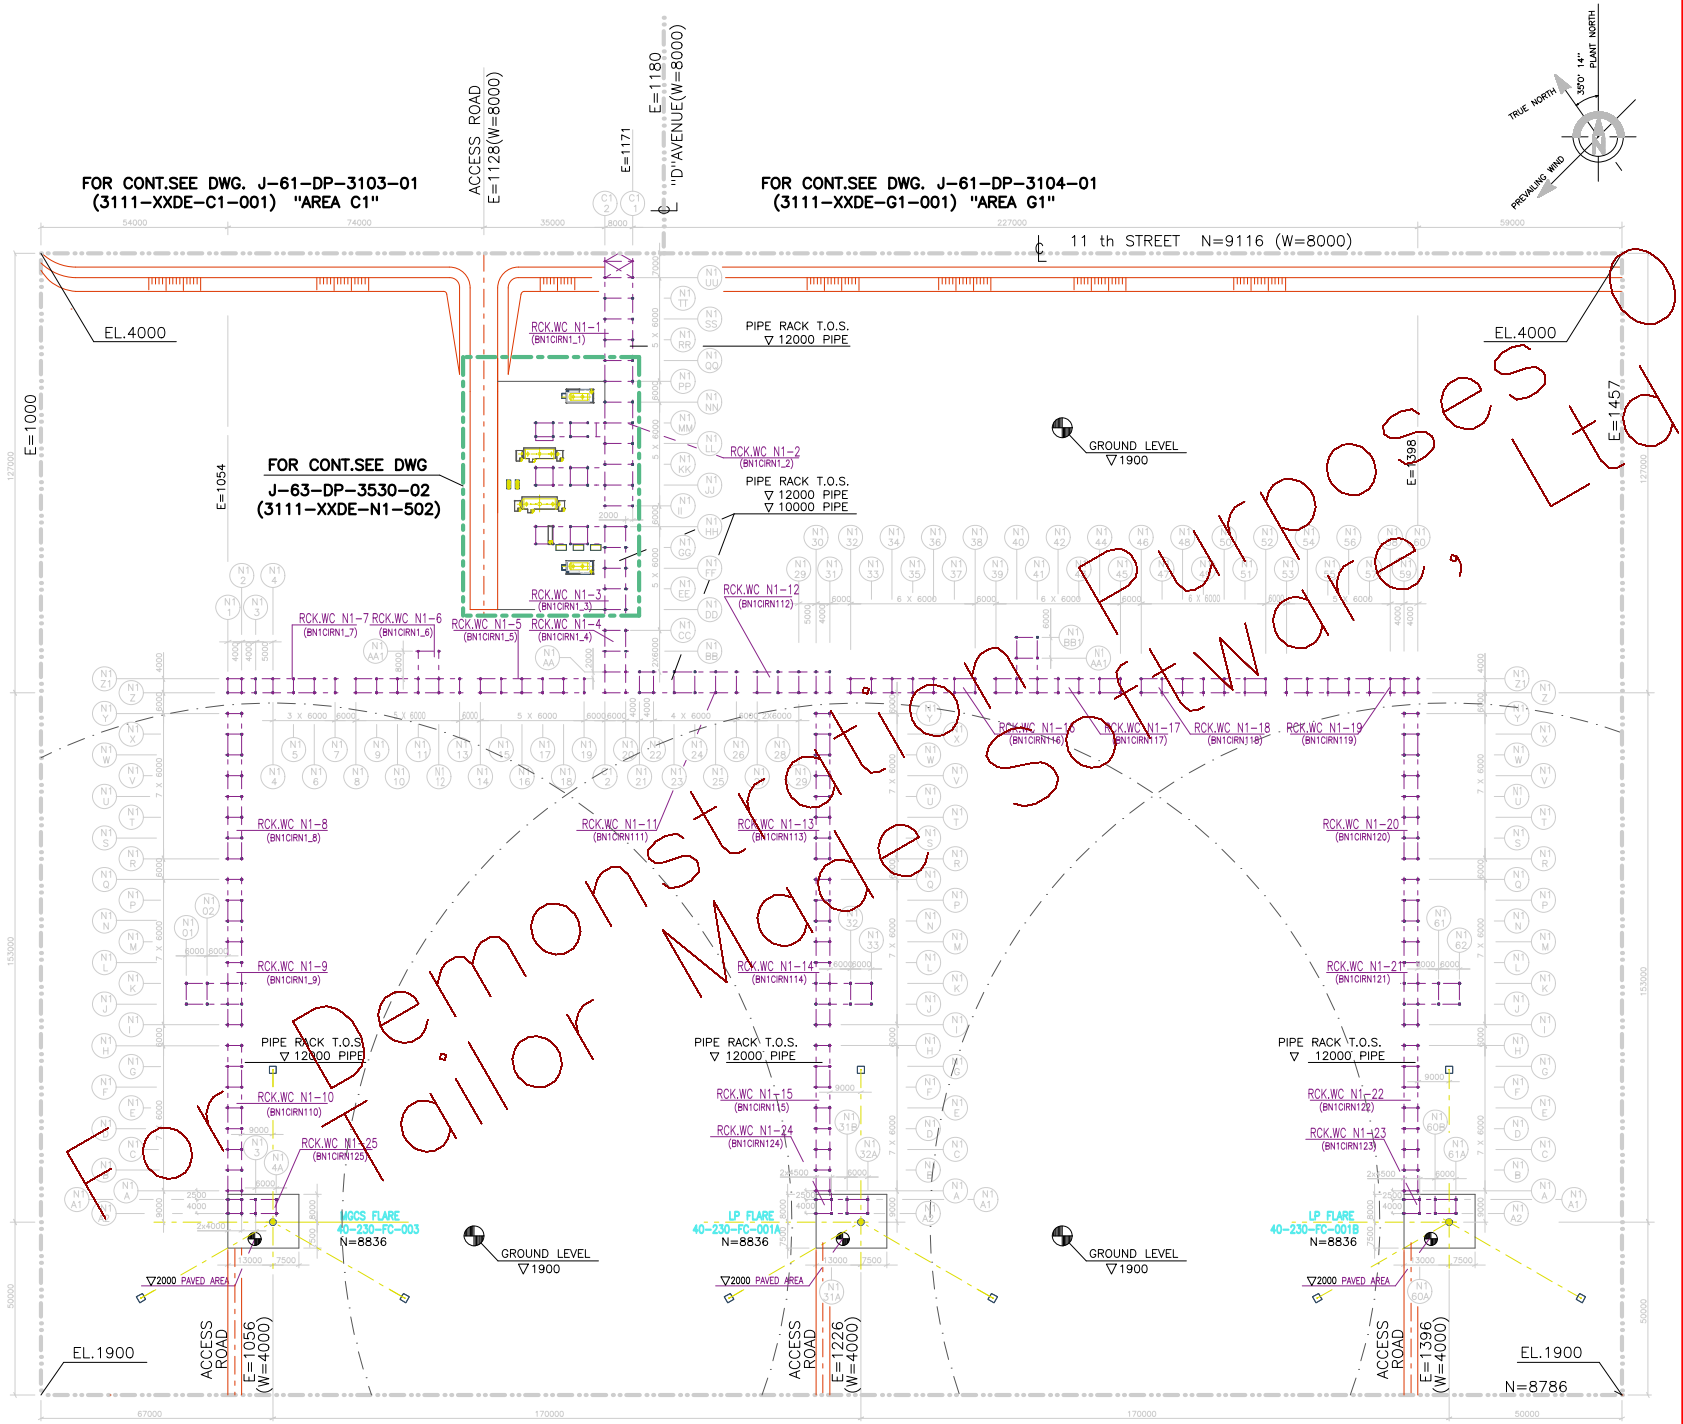

ELEVATION	ITEM	DESCRIPTION
T.O.C. +2200	40-230-FC-001A/B	lp flares
T.O.C. +2200	40-230-FC-003	MGCS flare

GENERAL NOTES

1) – ALL DIMENSIONS ARE IN MILLIMETERS
2) – ALL ELEVATIONS ARE IN MILLIMETERS
3) – ALL COORDINATES ARE IN METERS
4) DENOTES ZONE LIMITS
5) DENOTES PLANT LIMITS
6) – T.L. DENOTE TANGENT LINE EQUIPMENT
– T.O.S. DENOTES TOP OF STEEL
– T.O.C. DENOTE TOP OF CONCRETE
– B.O.E. DENOTE BOTTOM OF EQUIPMENT
– C.L. DENOTE CENTER LINE
– ▽ DENOTE GENERAL ELEVATION
7) – ALL ELEVATIONS ARE REFERRED TO M.S.L.
8) DENOTES FENCE

DRAWING No.	DESCRIPTION
J-10-1-F-3105-01	WAFA COASTAL PLANT(MELLITAH)-GENERAL PLOT PLAN
J-13-0-C-4014-14	UNDERGROUND GENERAL SERVICES UNIT "47"
J-15-1-F-3530-01	WAFA COASTAL PLANT(MELLITAH)-DETAILED PLOT PLAN ZONE N1
J-41-1-F-3201-01	WAFA COASTAL PLANT(MELLITAH)-GENERAL KEY PLAN
J-41-1-F-3201-11	WAFA COASTAL PLANT(MELLITAH)-OVERALL PLOT PLAN

REFERENCE DRAWINGS

LEGEND

SS — DENOTE SAFETY SHOWER AND EYES WASHING

U.S. ... — DENOTES UTILITY STATION

DENOTES LIMIT CONCRETE PAVING

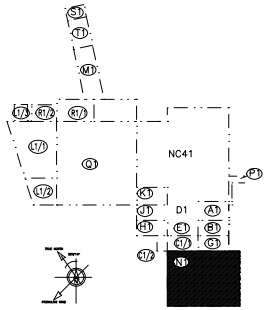

KEY – PLAN

AS BUILT

F1	14.12.2004	AS BUILT	DCR	VBM	ROJ
C2	"05.08"	UPDATED FOLLOWING C2	NRS	ABS	CML
C1	"05.02"	REVISED ISSUE FOR CONSTRUCTION (DOC. No. J-63-DP-3530-00)	GSC	ABS	CML
A1	"05.02"	ISSUED FOR APPROVAL	GSC	CMB	CML
REV.	DATE	DESCRIPTION	PREPARED	CHECKED	APPROVED / ENGINEERED	DRAWN

AgipGas BV Libyan Branch
WLGP – WAFA PLANTS
CONTRACT NR. 110/WA/02

JTS CONTRACTING COMPANY LTD.

COASTAL PLANT
DETAILED PLOT PLAN
ZONE N1

Plant Area	Plot/Dealer or Tab ID	Plant Unit	DWG Scale
N1	63	B144	1:750

Company Contracts No.	Company DWG No.	Sheet
110/WA/02	J-63-DP-3530-01	1 of 1

Contractor Job No.	Contractor DWG No.	Rev.	Size
3111	3111-XXDE-N1-501	F1	A1

PC WBS

DISTRIBUTION
COMPANY
TWPD
ROMS
PMB
VDC
MDC
SDCD
SDCC
JGC
PMB
VDC
MDC
SDCD
SDCC
TWPD
MMS
JGC INTERNAL

For Demonstration Purposes Only
Trailor Made Software, Ltd

THIS PRINT IS A CONFIDENTIAL NATURE AND IS THE PROPERTY OF JGC COPRATION, JAPAN AND SHALL NOT BE TRACED, PHOTOGRAPHED, PHOTOSTATES OR REPRODUCED IN ANY MANNER, NOR USED PURPOSE WHATEVER EXPECT BY WRITTEN PERMISSION OF JGC CORPORATION.

CHANGEMENT DE WORK UNITS LE 25/03/02 POUR CONFORMITE WORK UNITS DE MAQUETTE SZ